


EDGEWATER COMMERCE CENTER

6250 Edgewater Drive
Orlando, Florida 32907

12.06.10

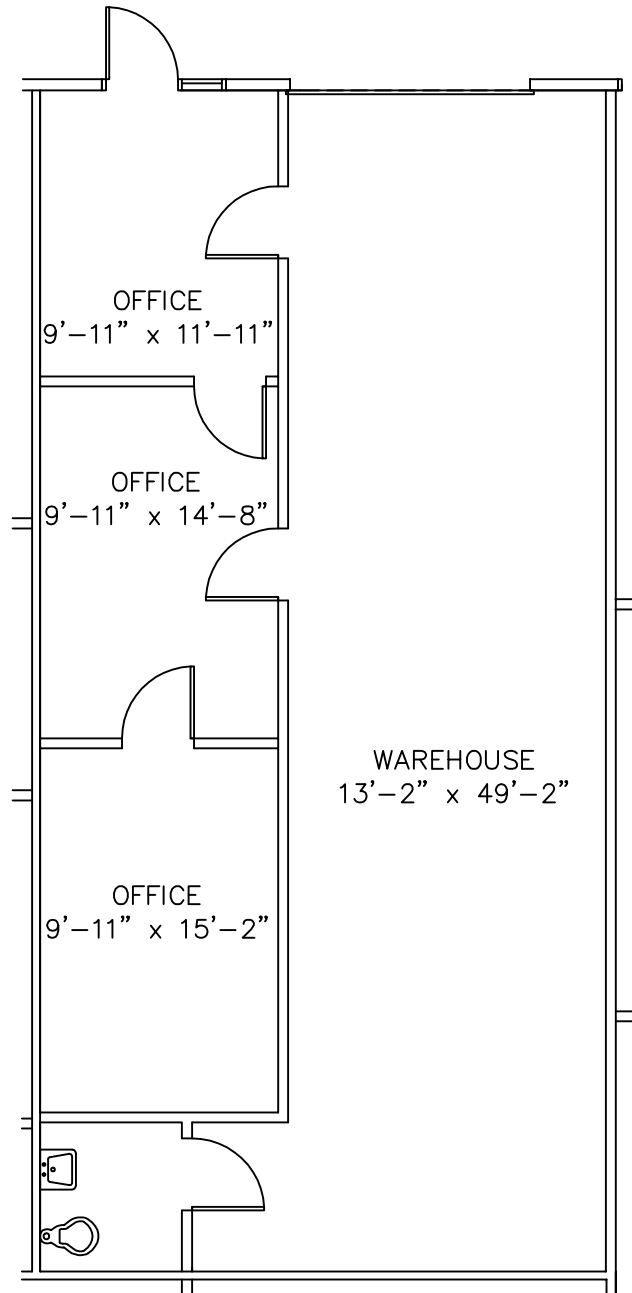

SUITE 2900 AS-BUILT 1,200 SF

1/8" = 1'

