


Edgewater Commerce Center

6250 Edgewater Drive
Orlando, Florida 32907

9.11.09

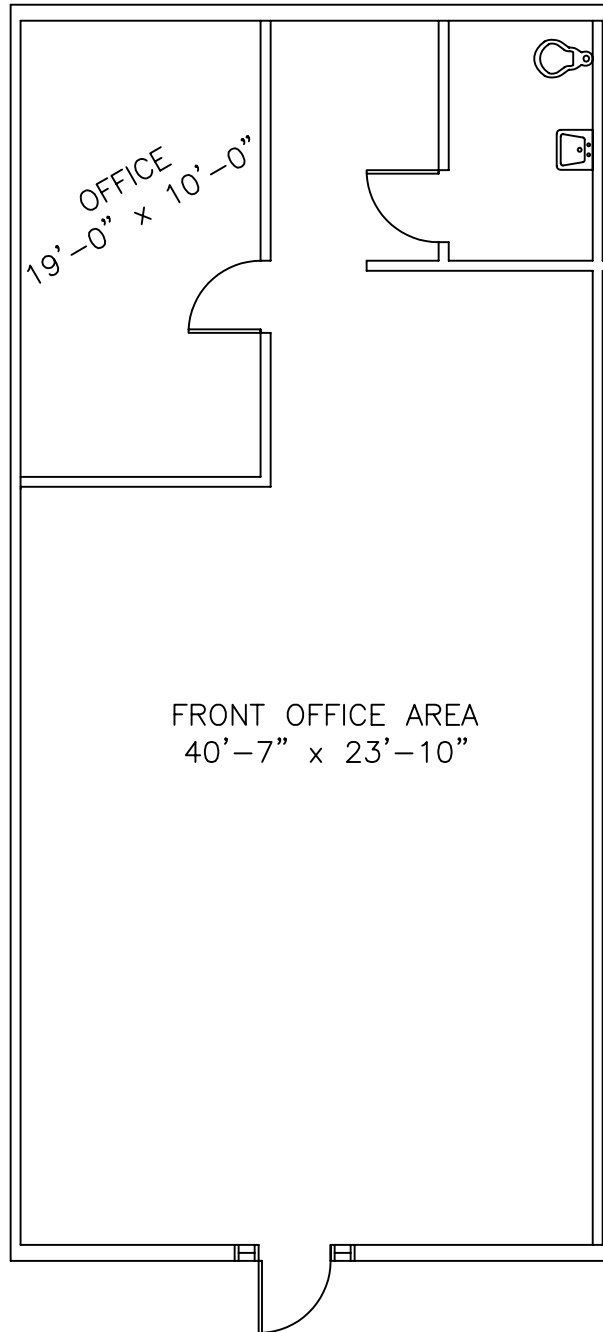

SUITE 300 AS-BUILT 1,275 SF

1/8" = 1'

