


Edgewater Commerce Center

6250 Edgewater Drive
Orlando, Florida 32907

12.06.10

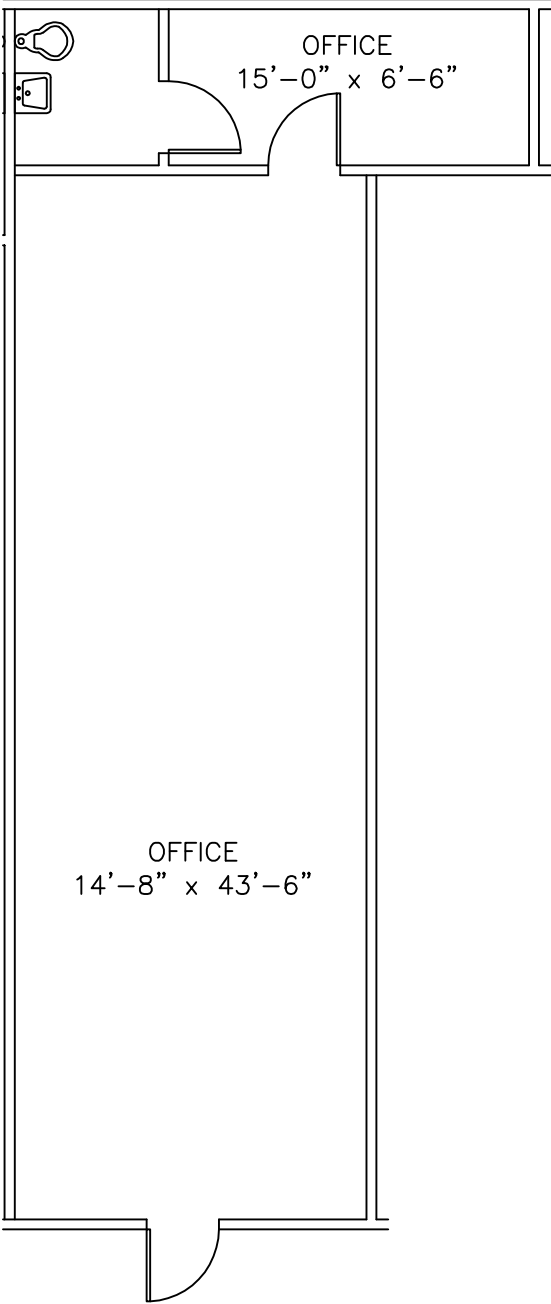

SUITE 400 AS-BUILT 815 SF

1/8" = 1'

