


# EDGEWATER COMMERCE CENTER

6270 Edgewater Drive  
Orlando, Florida 32907

12.04.09

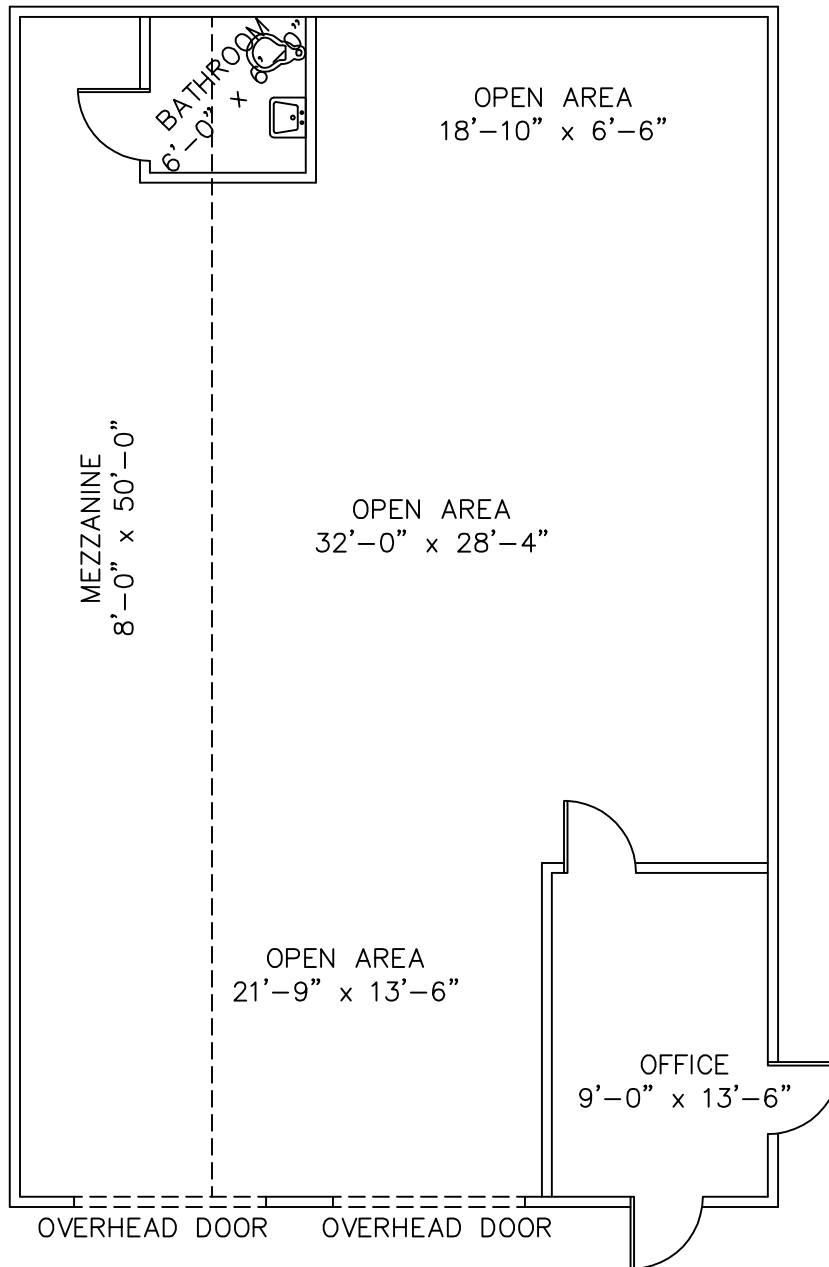

SUITE 3300 AS-BUILT 1,600 SF

1/8" = 1'

