


EDGEWATER COMMERCE CENTER

6270 Edgewater Drive
Orlando, Florida 32907
12.07.09

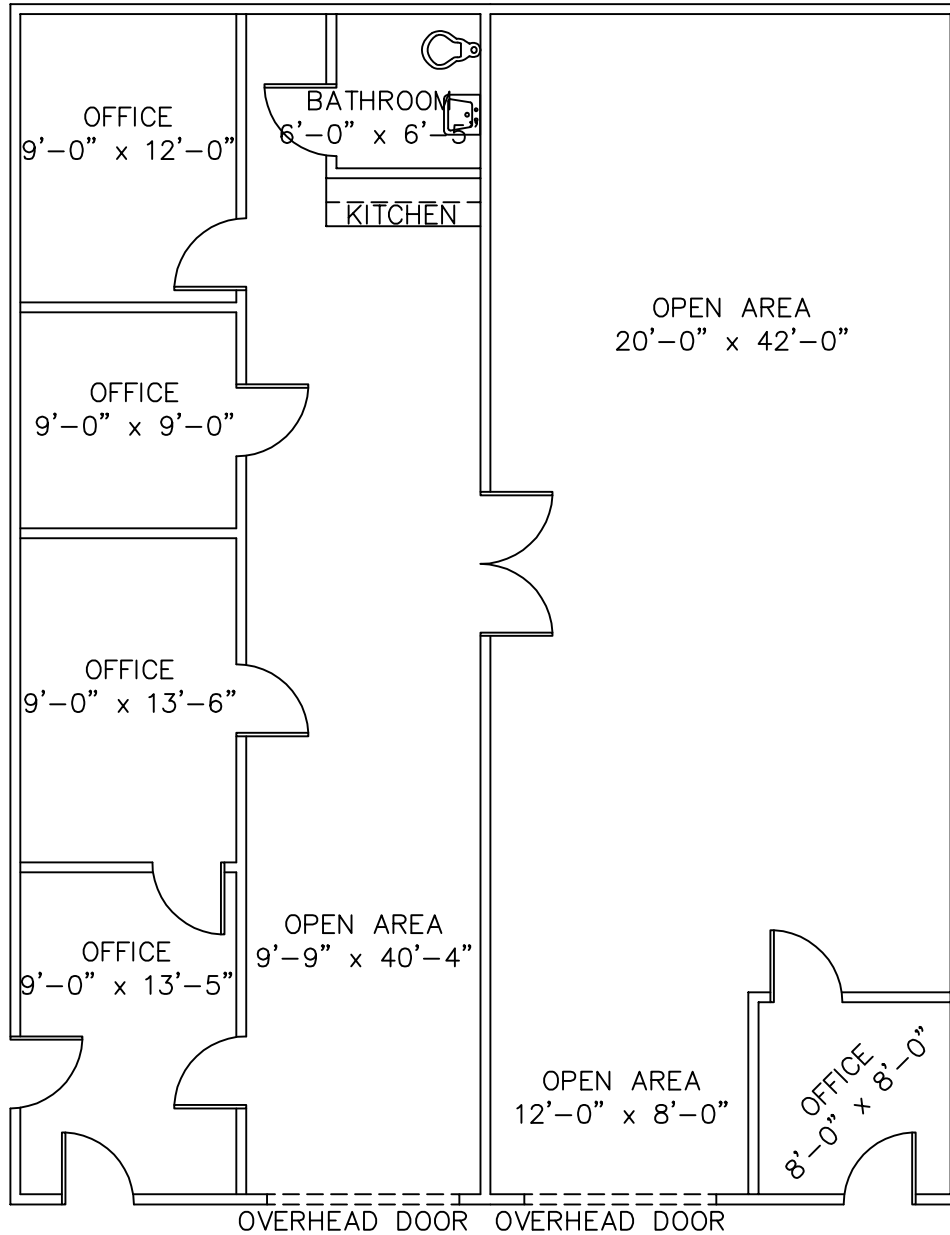

SUITE 3400 AS-BUILT 2,000 SF

1/8" = 1'

