


# EDGEWATER COMMERCE CENTER

6270 Edgewater Drive  
Orlando, Florida 32907  
12.04.09

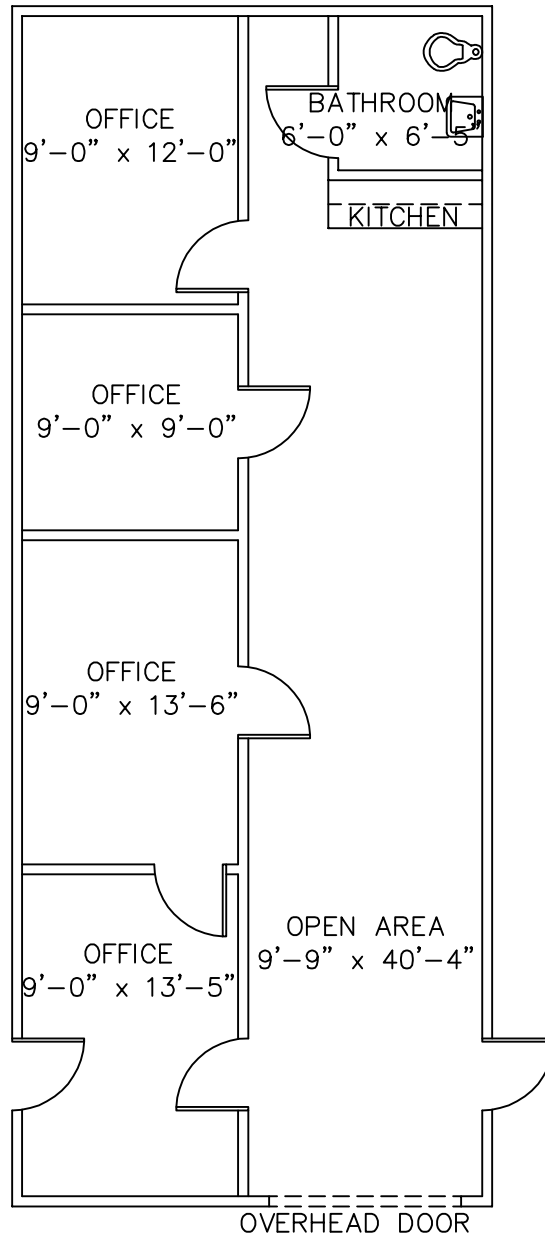

SUITE 3400 AS-BUILT 1,000 SF

1/8" = 1'

