


EDGEWATER COMMERCE CENTER

6270 Edgewater Drive
Orlando, Florida 32907

12.08.09

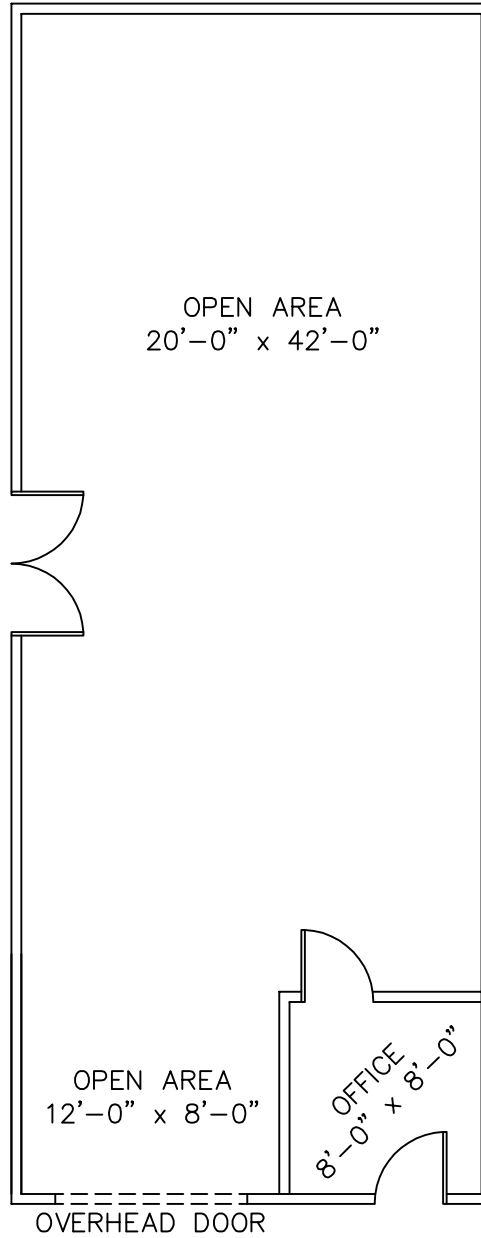

SUITE 3500 AS-BUILT 1,000 SF

1/8" = 1'

