


Edgewater Commerce Center

6270 Edgewater Drive
Orlando, Florida 32907

6.3.09

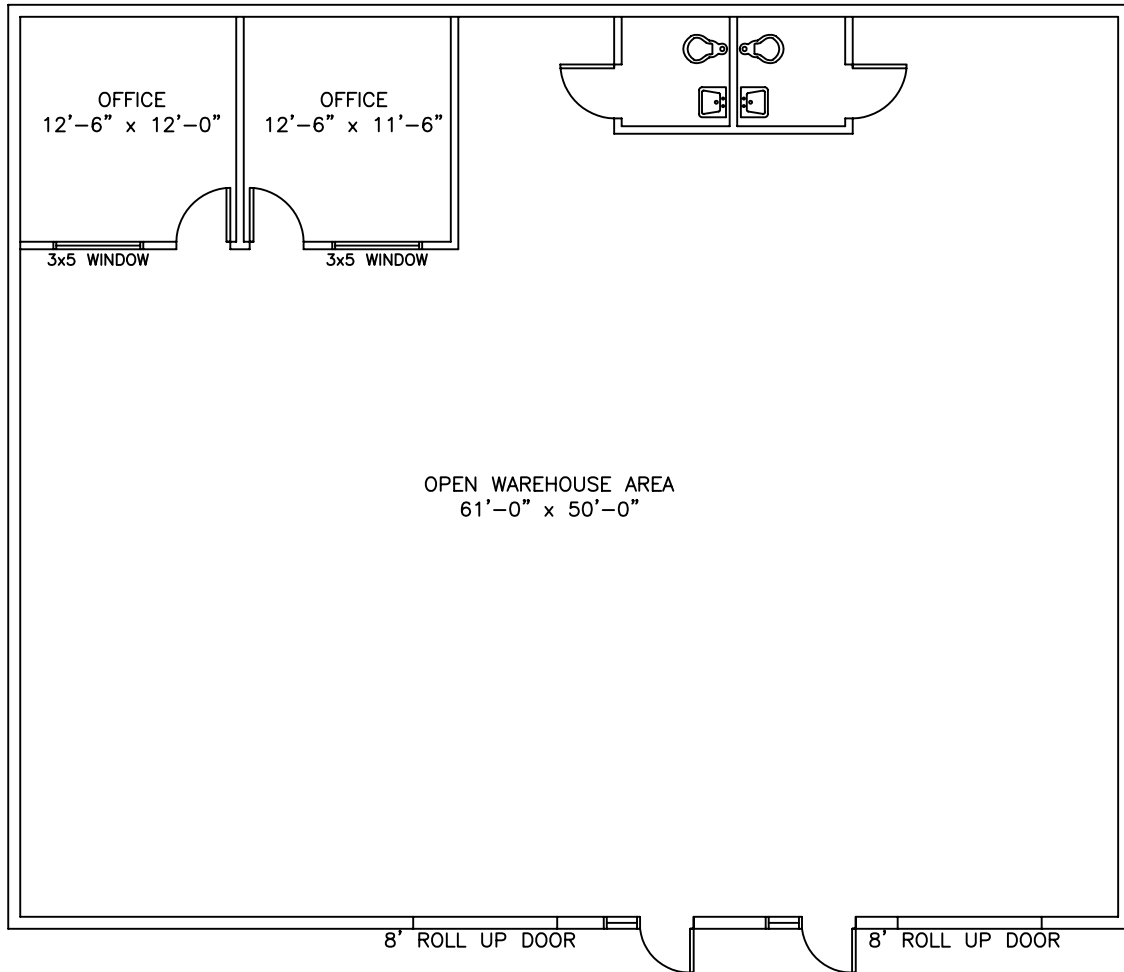

SUITE 4600 AS-BUILT 3,200 SF

3/32" = 1'

