


Edgewater Commerce Center

6270 Edgewater Drive
Orlando, Florida 32907

3.18.09

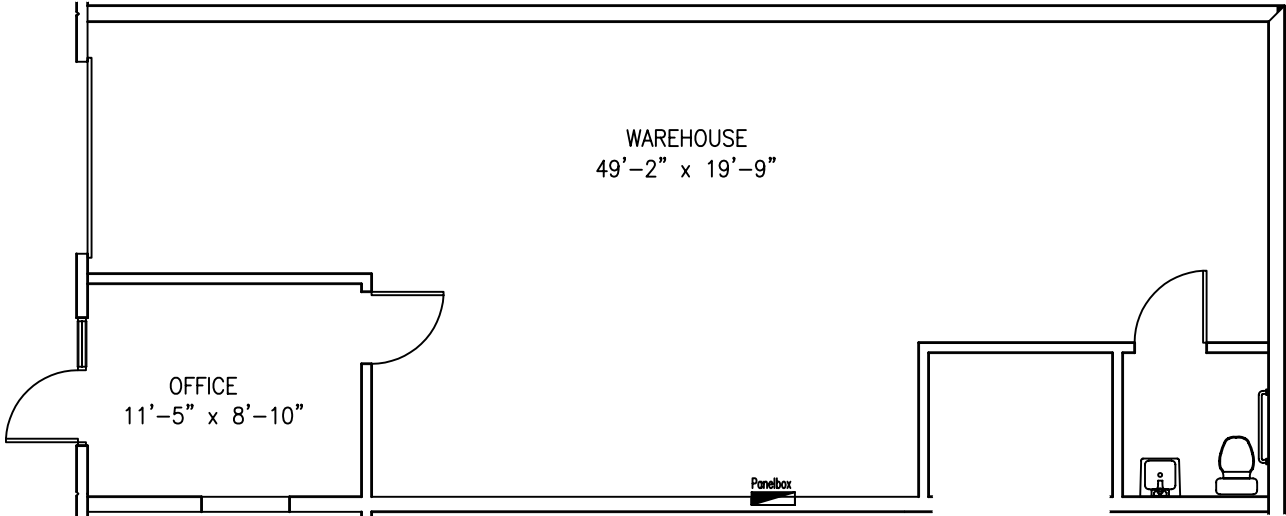

SUITE 5100 AS-BUILT 900 SF

1/18" = 1'

