


# Edgewater Commerce Center

6270 Edgewater Drive  
Orlando, Florida 32907

1.09.09

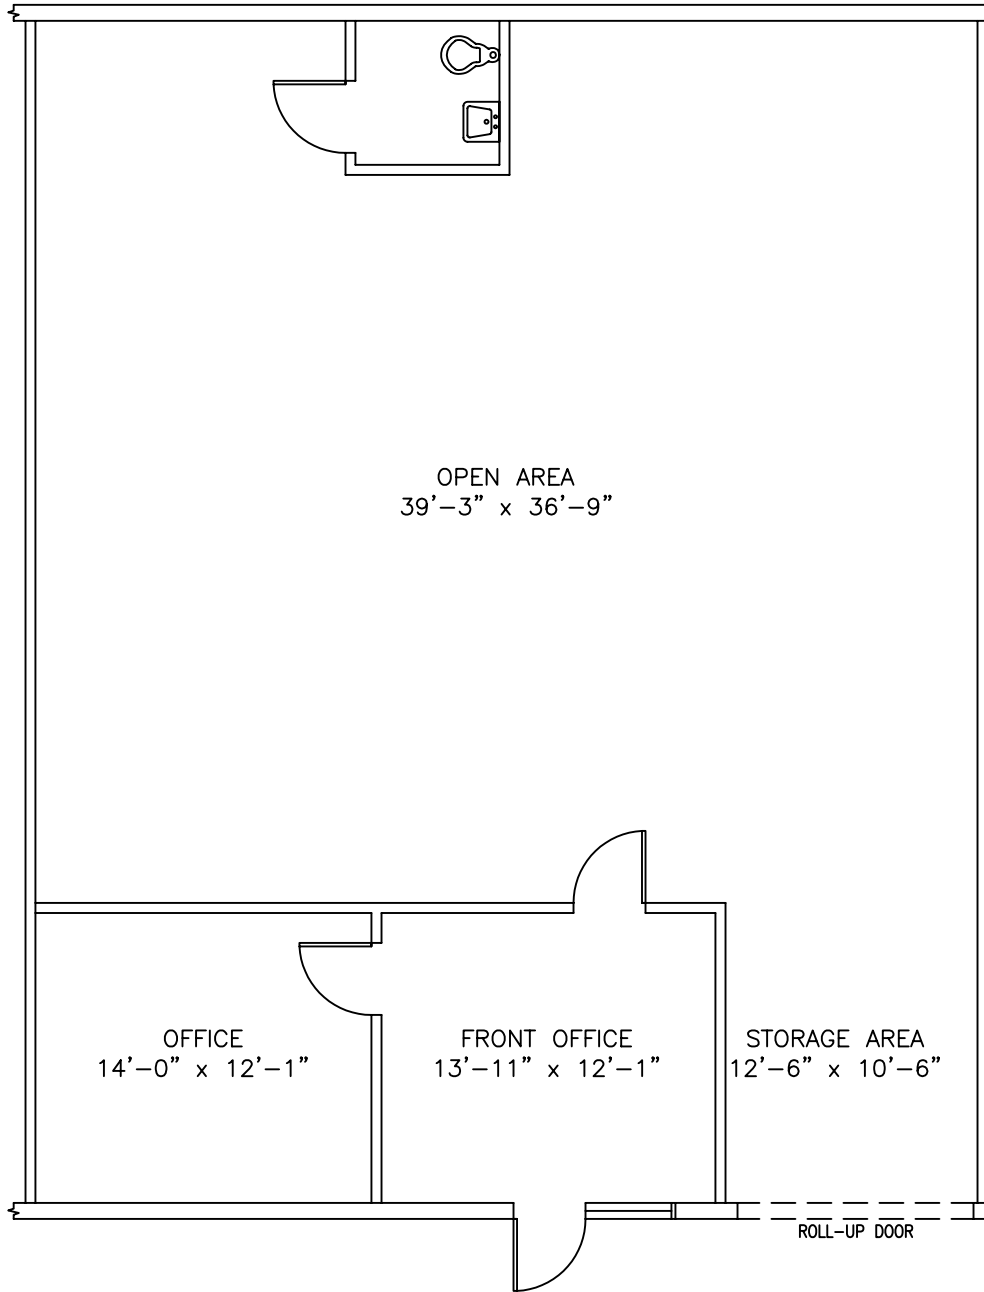

SUITE 5300 AS-BUILT

2,007 SF

1/18" = 1'

