


Kennedy Commerce Center

995 W. Kennedy Blvd.
Orlando, Florida 32810

05.25.08

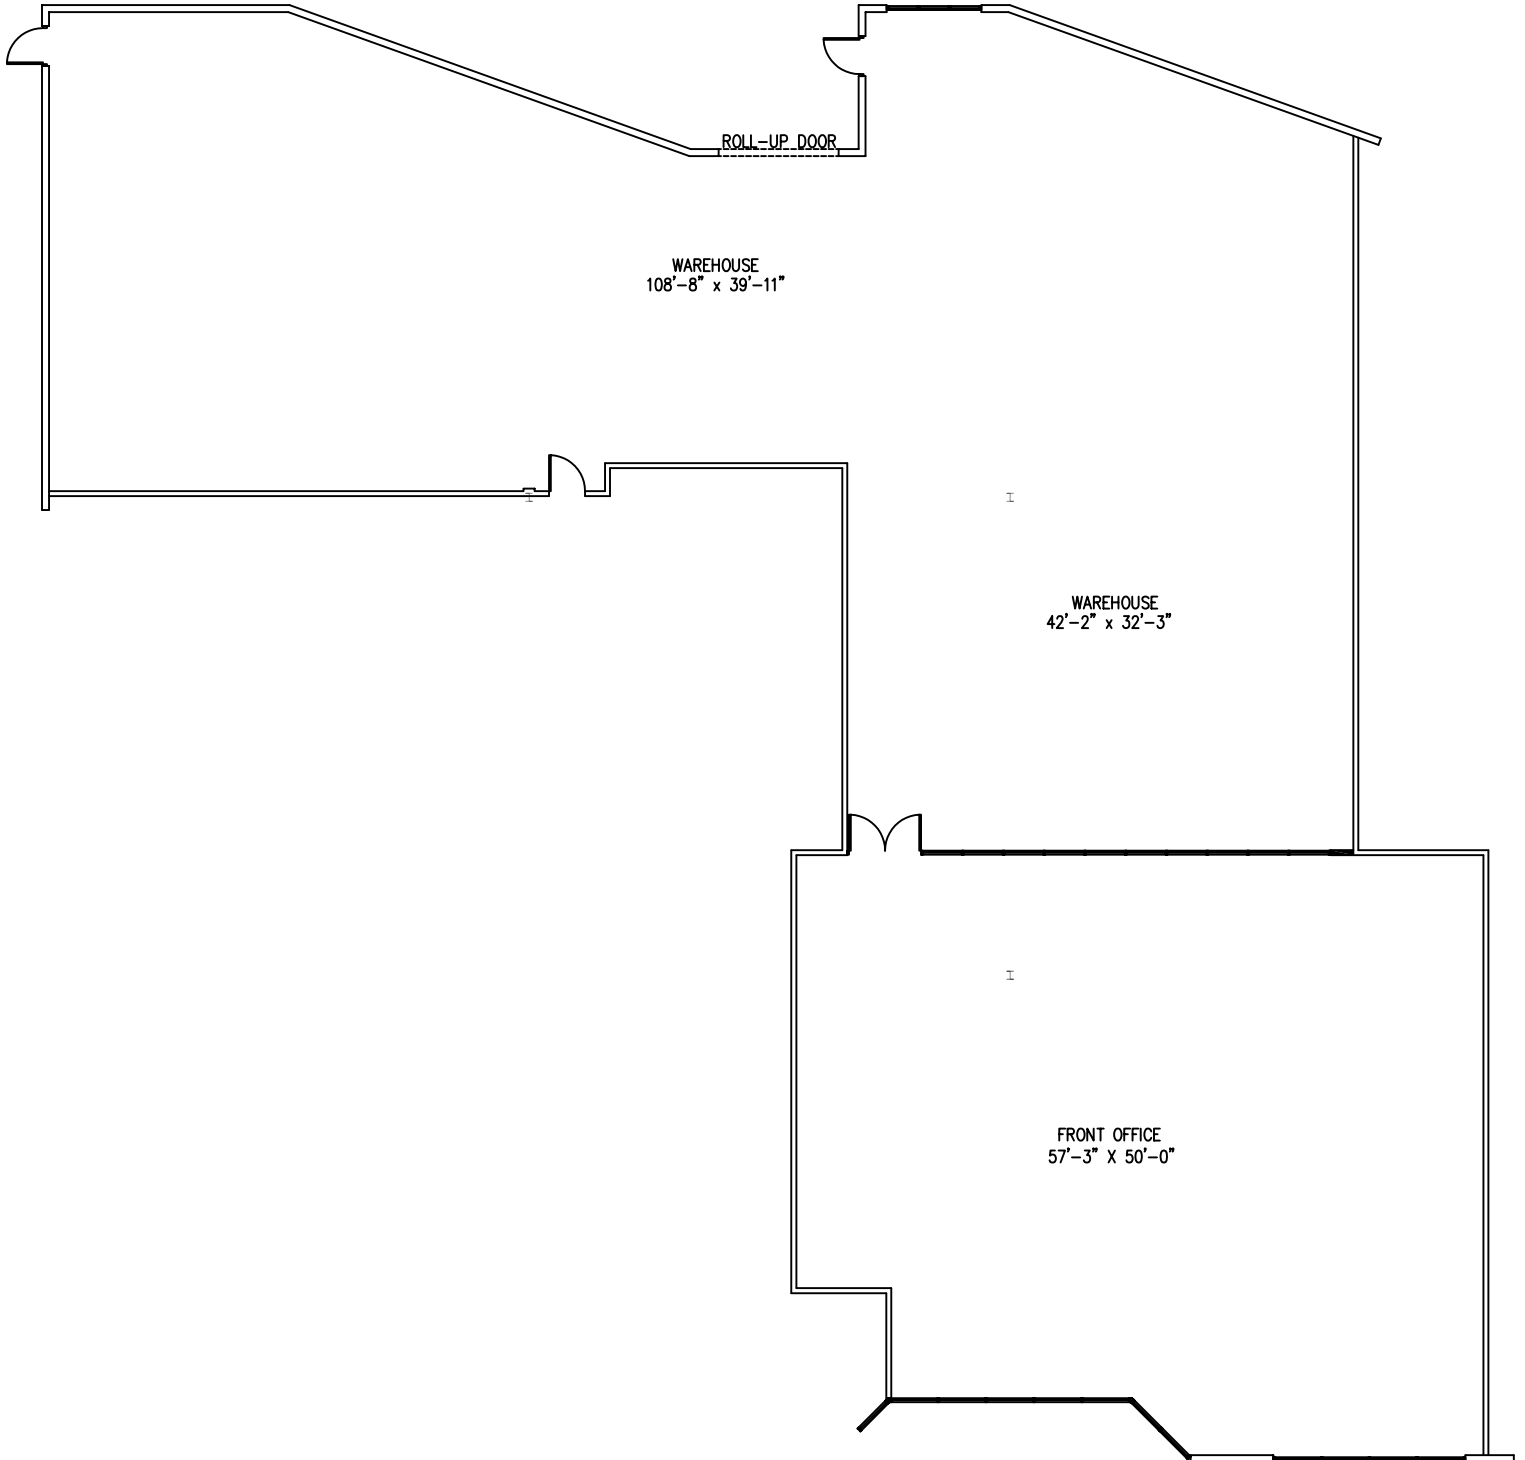

SUITE 15 AS-BUILT 7,928 SF

1/16" = 1'

