


Kennedy Commerce Center

997 W. Kennedy Blvd.
Orlando, Florida 32810

05.26.08

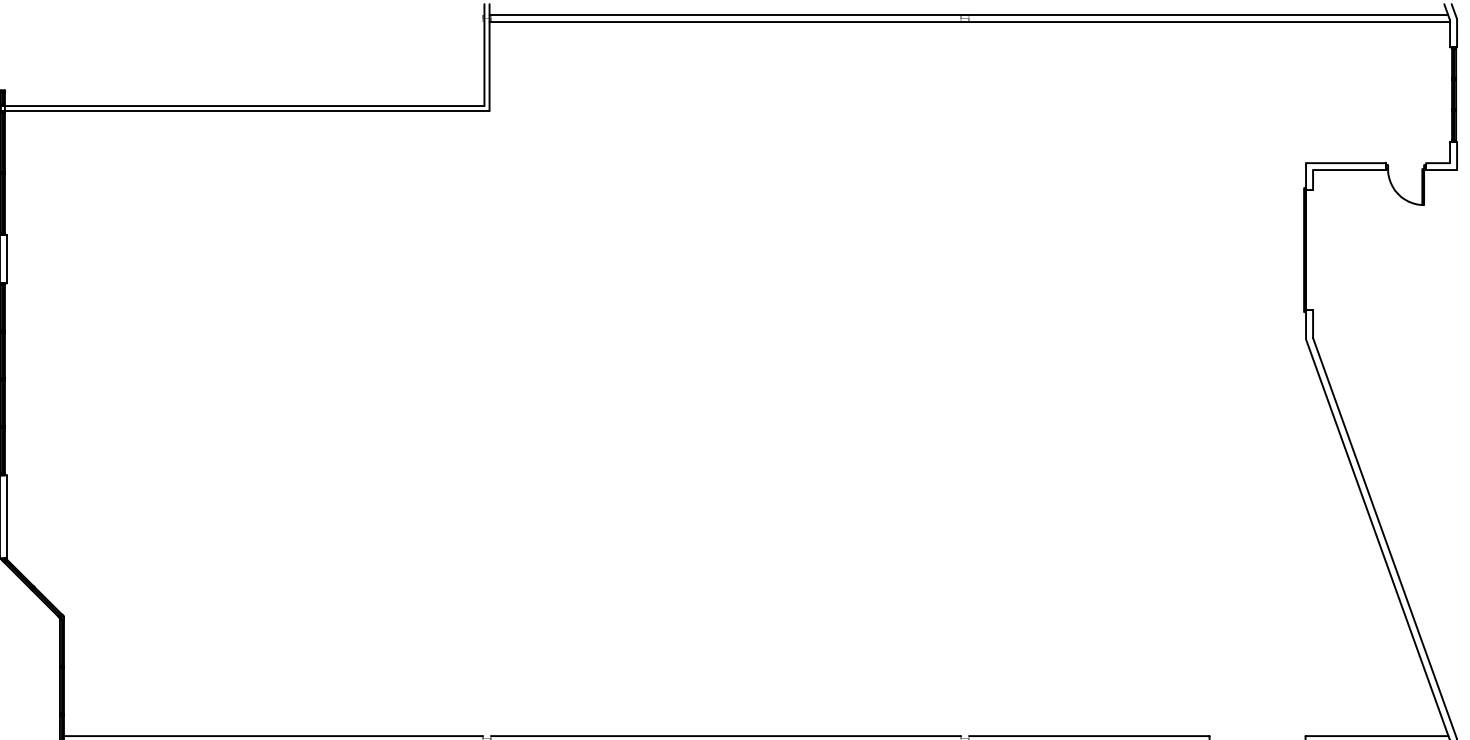

Suite 3 AS-BUILT

6,559 SF

1/16" = 1'

