


KENNEDY COMMERCE CENTER

997 W. Kennedy Blvd
Orlando, Florida 32810

09.21.10

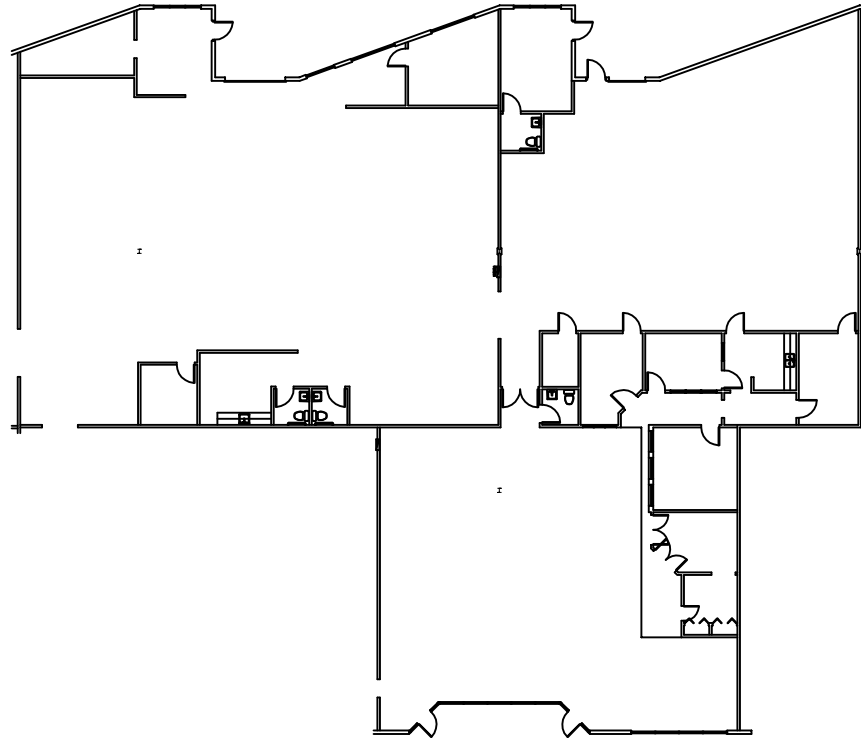

SUITE 5&6 AS-BUILT 12,173 SF

1/32" = 1'

