


KENNEDY COMMERCE CENTER

997 W. Kennedy Blvd
Orlando, Florida 32810

09.21.10

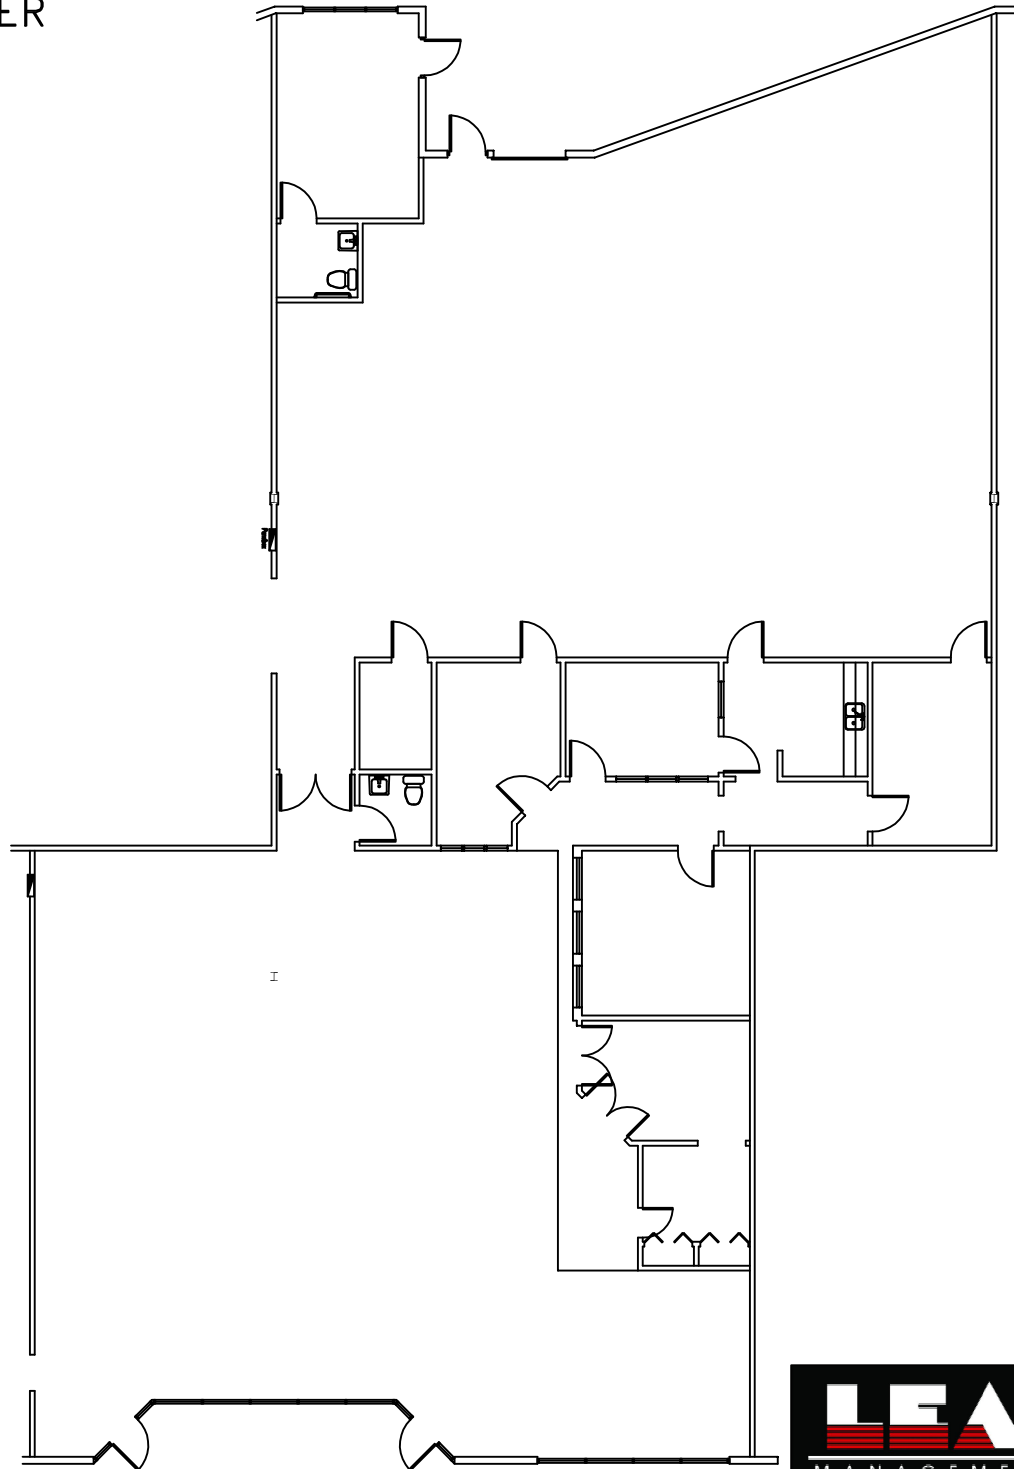

SUITE 6 AS-BUILT

7,000 SF

1/16" = 1'

