


KIRKMAN COMMERCE CENTER

745 Kirkman Road
Orlando, Florida 32811

03.07.09

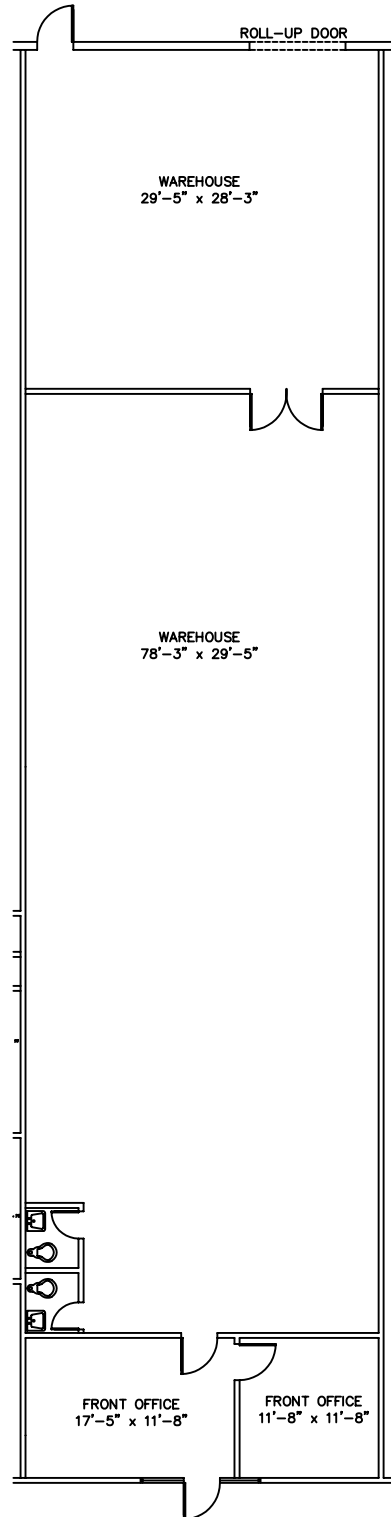

SUITE 751 AS-BUILT 3,583 SF

1/16" = 1'

