


KIRKMAN COMMERCE CENTER

771 S. Kirkman Road
Orlando, Florida 32811

11.26.08

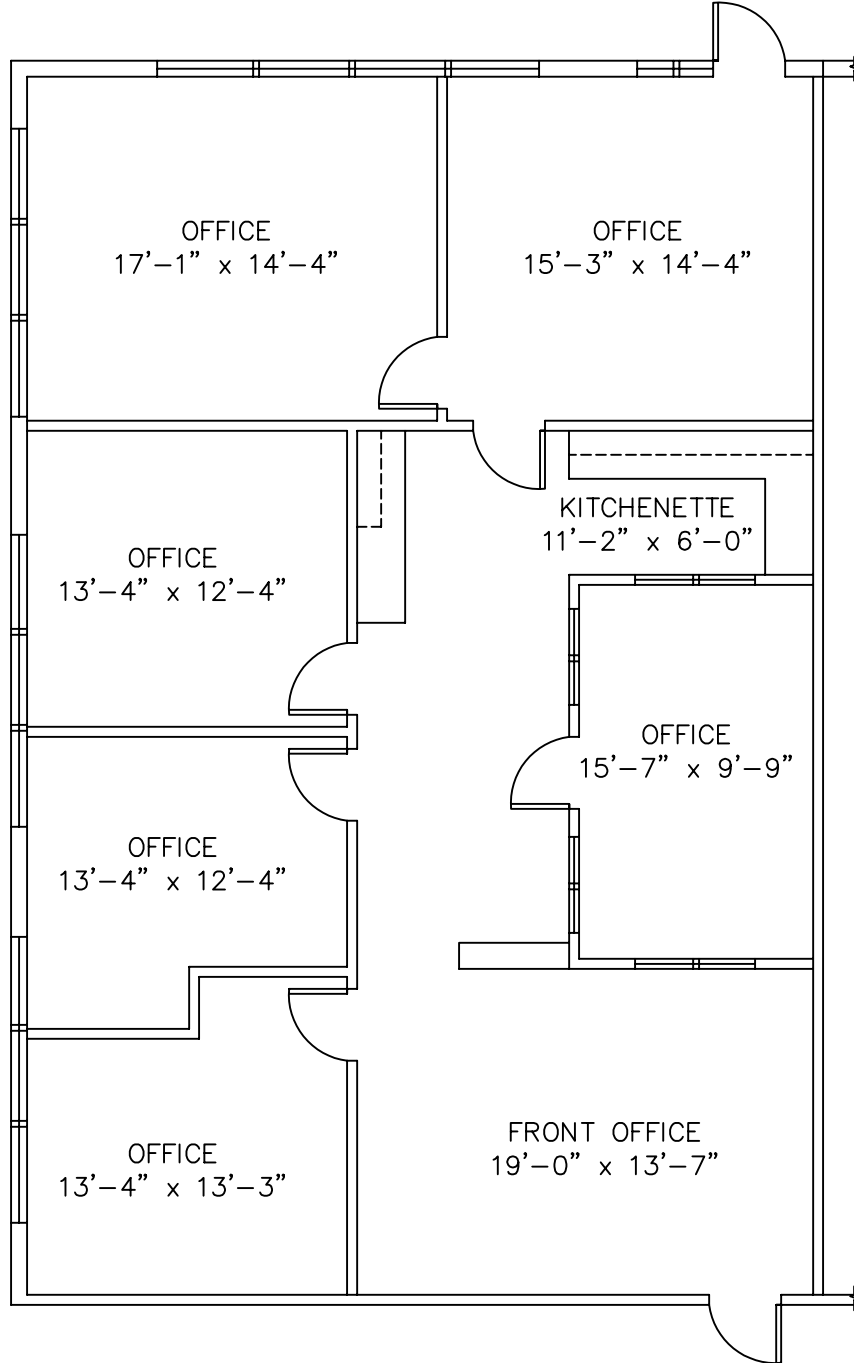

SUITE 107 AS-BUILT 1,973 SF

1/8" = 1'

