


# KIRKMAN COMMERCE CENTER

775 S. Kirkman Road  
Orlando, Florida 32811

12.04.09

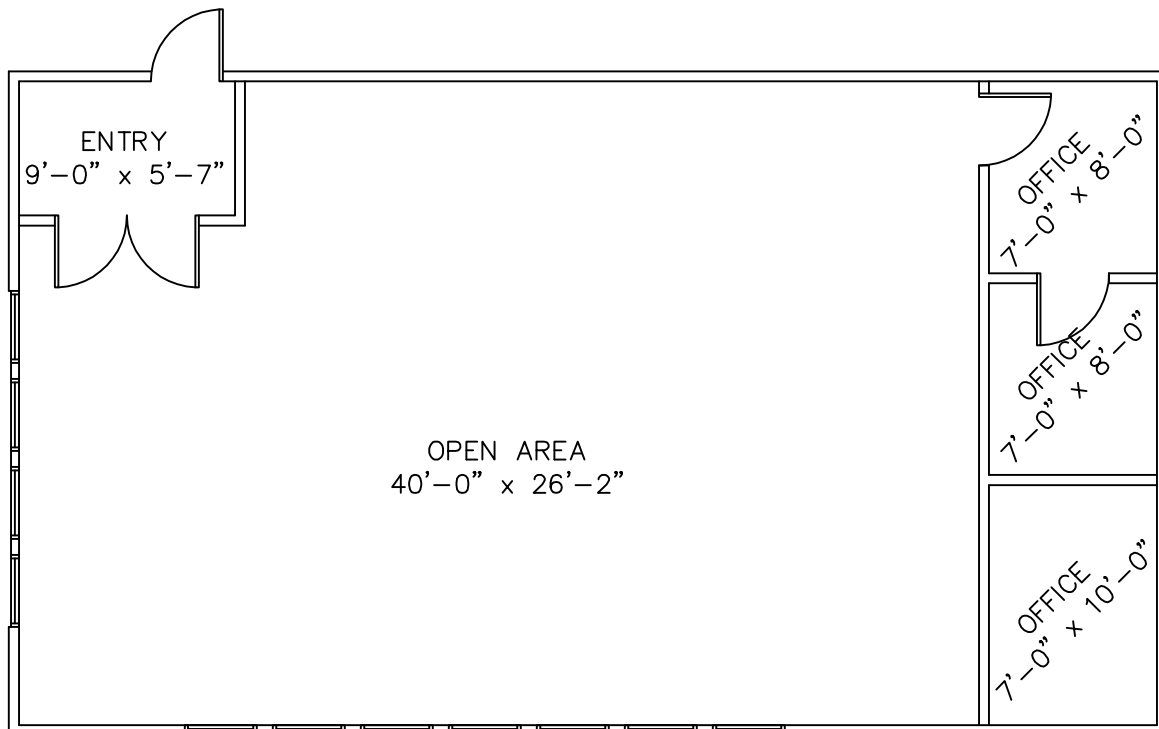

SUITE 101 AS-BUILT 1,540 SF

1/8" = 1'

