


KIRKMAN COMMERCE CENTER

775 S. Kirkman Road
Orlando, Florida 32811

12.09.08

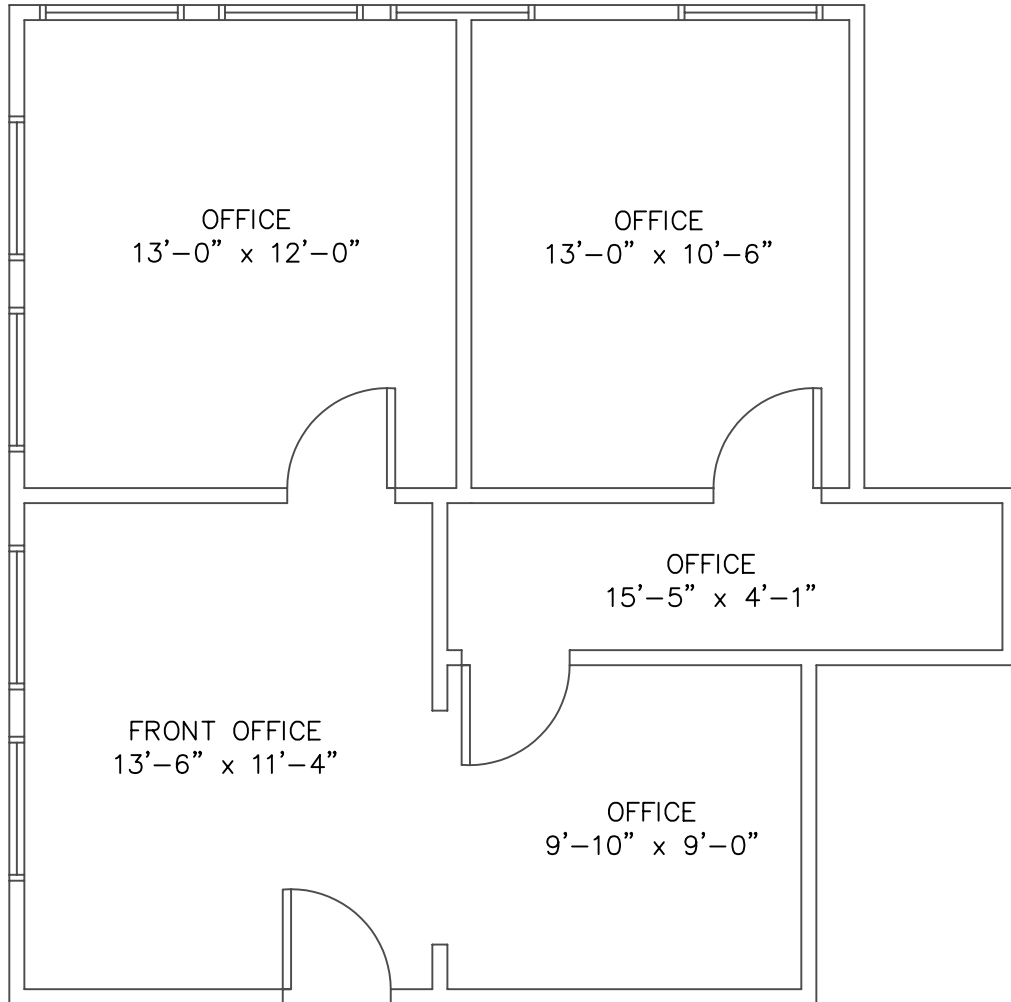

SUITE 111 AS-BUILT 767 SF

3/16" = 1'

