


WINTER GARDEN BUSINESS PARK

1218 Winter Garden Vineland Road
Winter Garden, Florida 34787

2.18.09

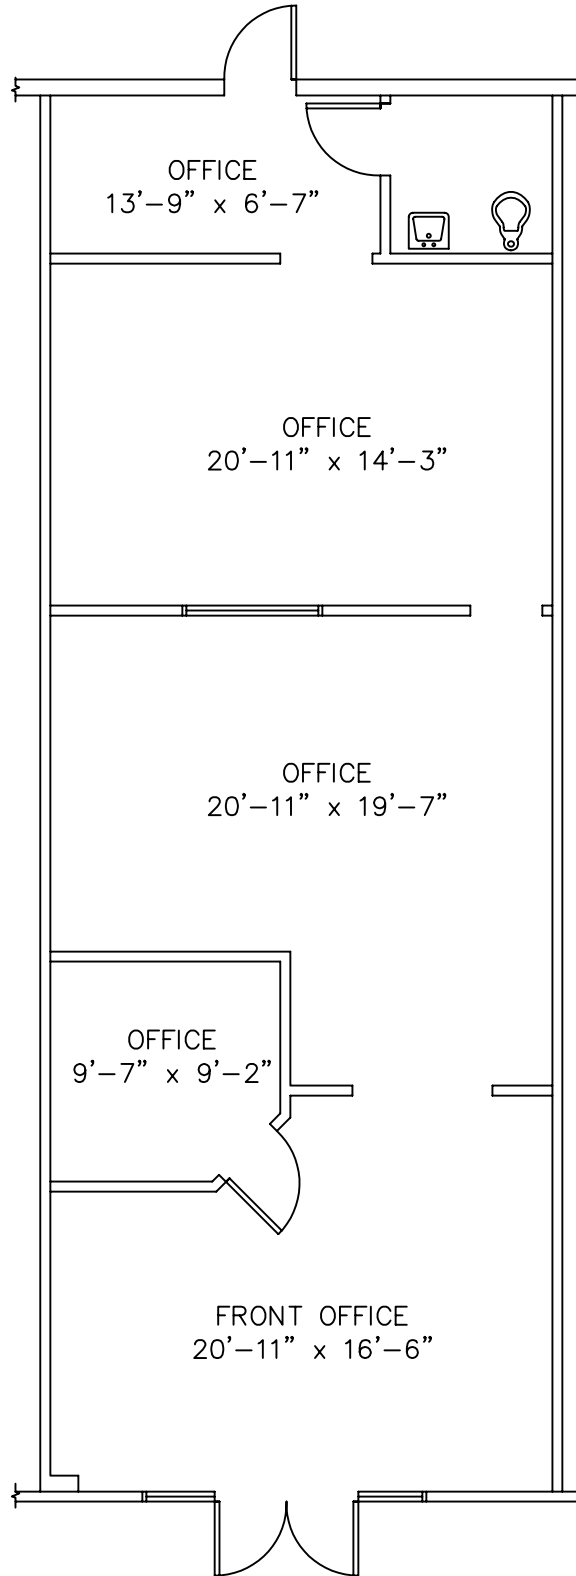

SUITE 104 AS-BUILT 1,296 SF

1/8" = 1'

