


# WINTER GARDEN BUSINESS PARK

1218 Winter Garden Vineland Road  
Winter Garden, Florida 34787

11.19.08

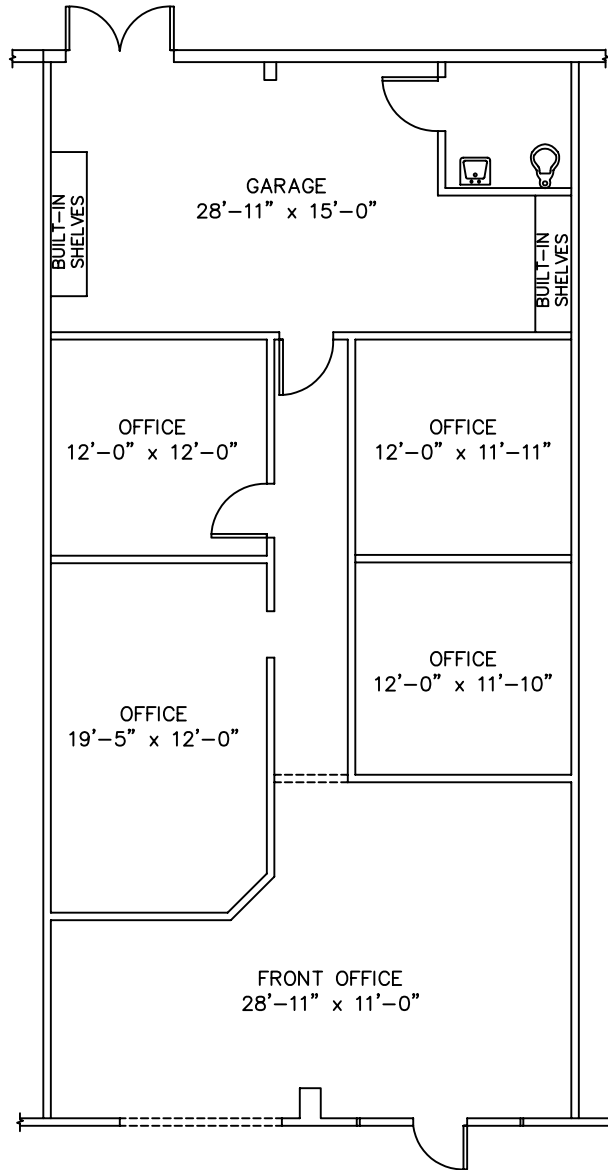

SUITE 112 AS-BUILT 1,753 SF

3/32" = 1'

