


WINTER GARDEN BUSINESS PARK

1218 Winter Garden Vineland Road
Winter Garden, Florida 34787

1.10.09

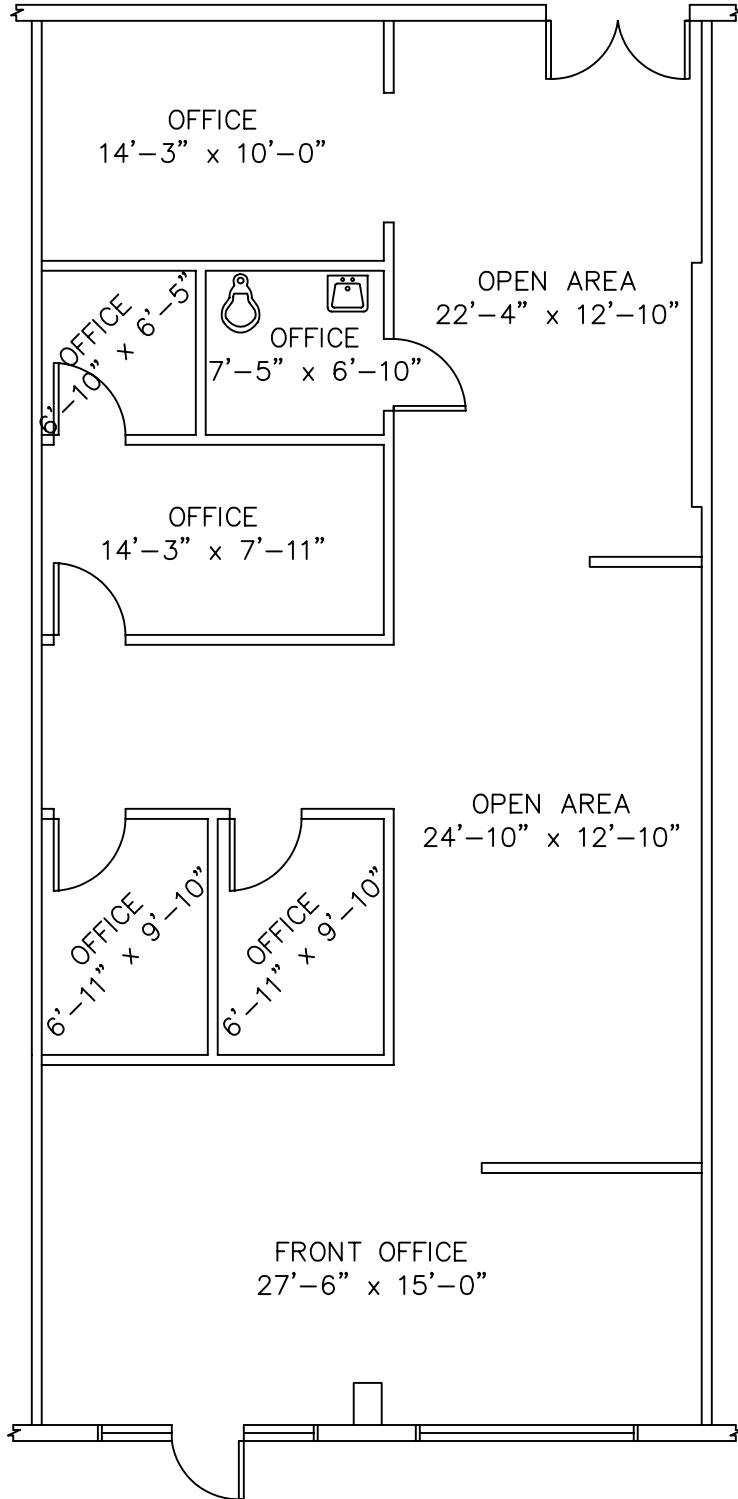

SUITE 116 AS-BUILT 1,680 SF

1/8" = 1'

