


WINTER GARDEN BUSINESS PARK

1224 Winter Garden Vineland Road
Winter Garden, Florida 34787

2.18.09

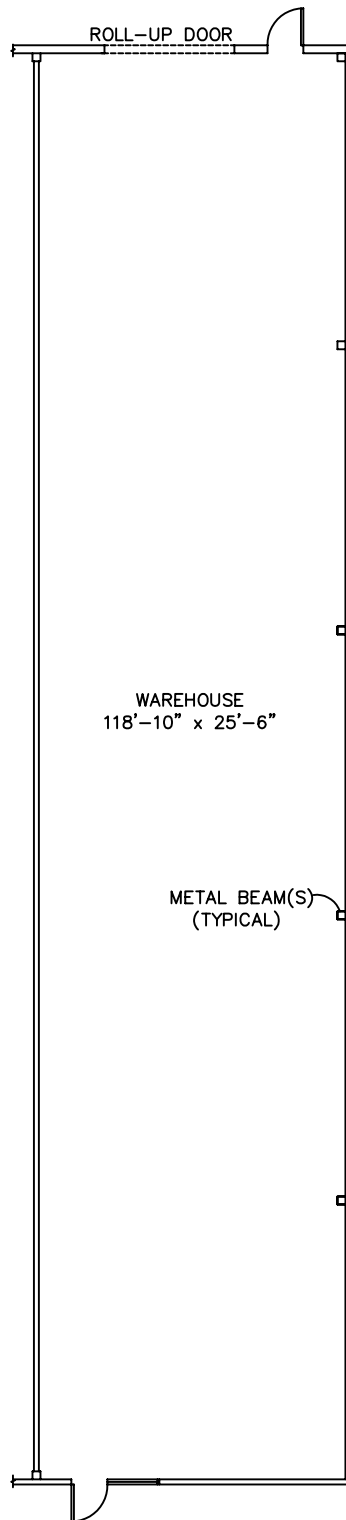

SUITE 100 AS-BUILT 3,168 SF

1/16" = 1'

