


# WINTER GARDEN BUSINESS PARK

1224 Winter Garden Vineland Road  
Winter Garden, Florida 34787

2.18.09

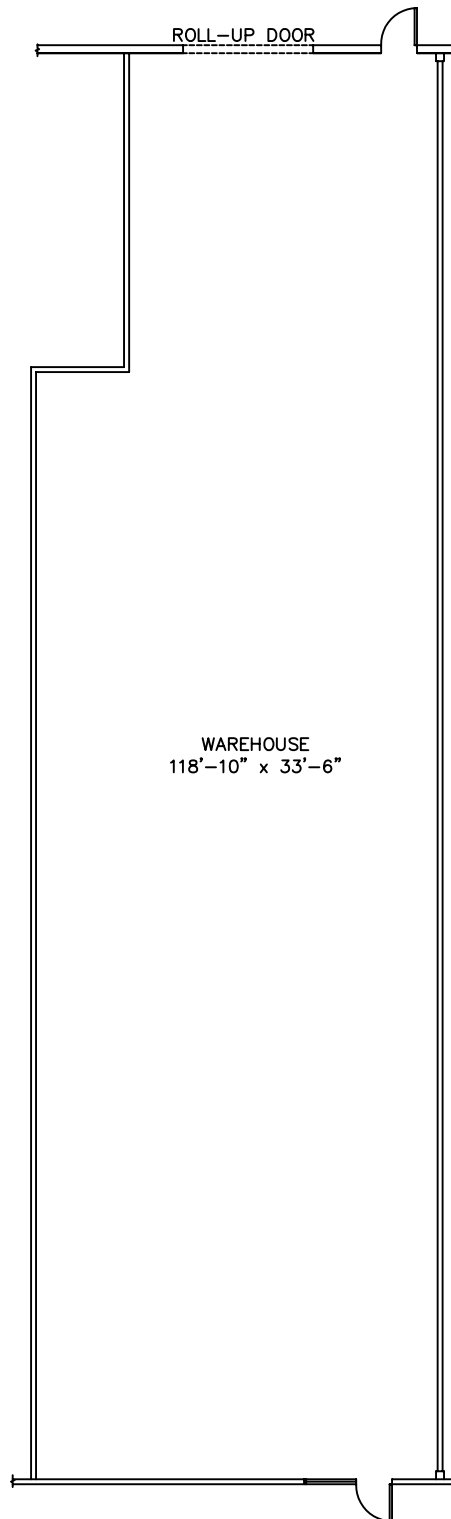

SUITE 104 AS-BUILT 3,854 SF

1/16" = 1'

