


# WINTER GARDEN BUSINESS PARK

1226 Winter Garden Vineland Road  
Winter Garden, Florida 34787

04.21.08

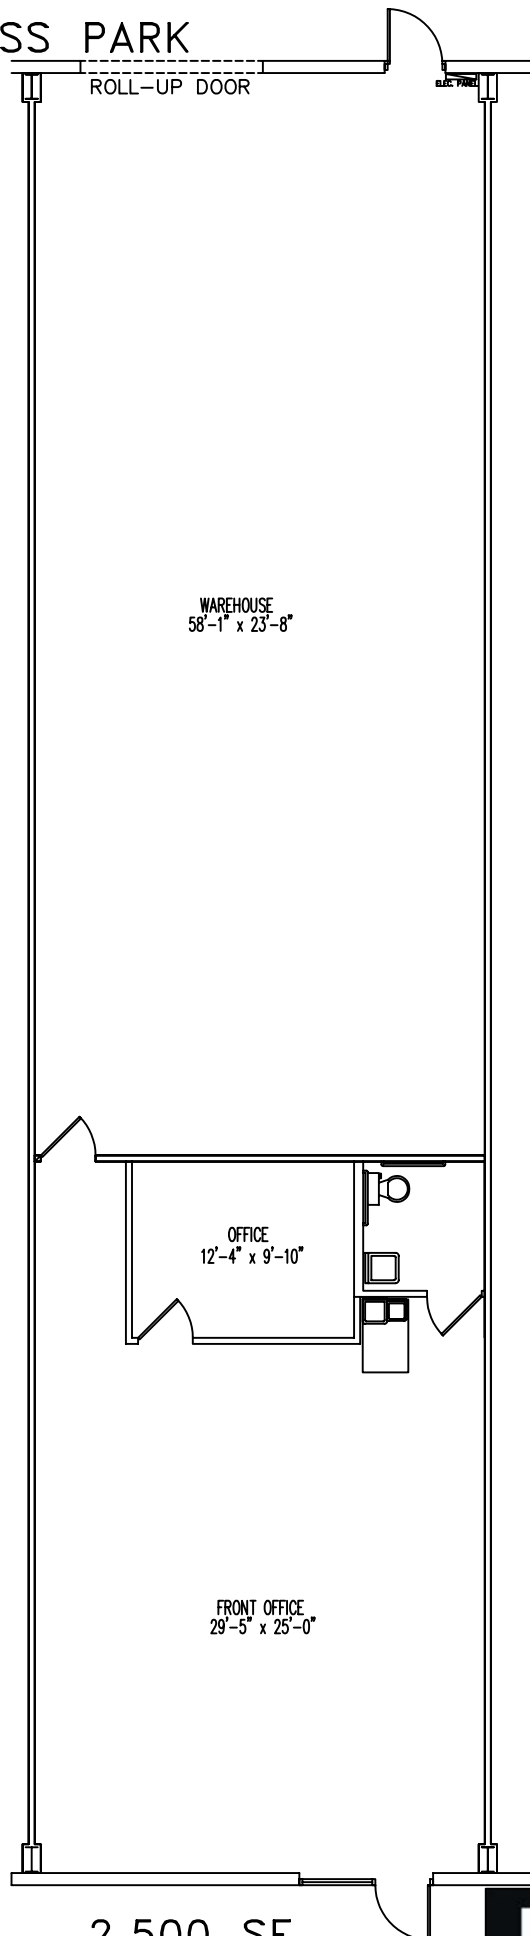

SUITE 108 AS-BUILT 2,500 SF

3/32" = 1'

