


WINTER GARDEN BUSINESS PARK

1232 Winter Garden Vineland Road
Winter Garden, Florida 34787

07.19.08

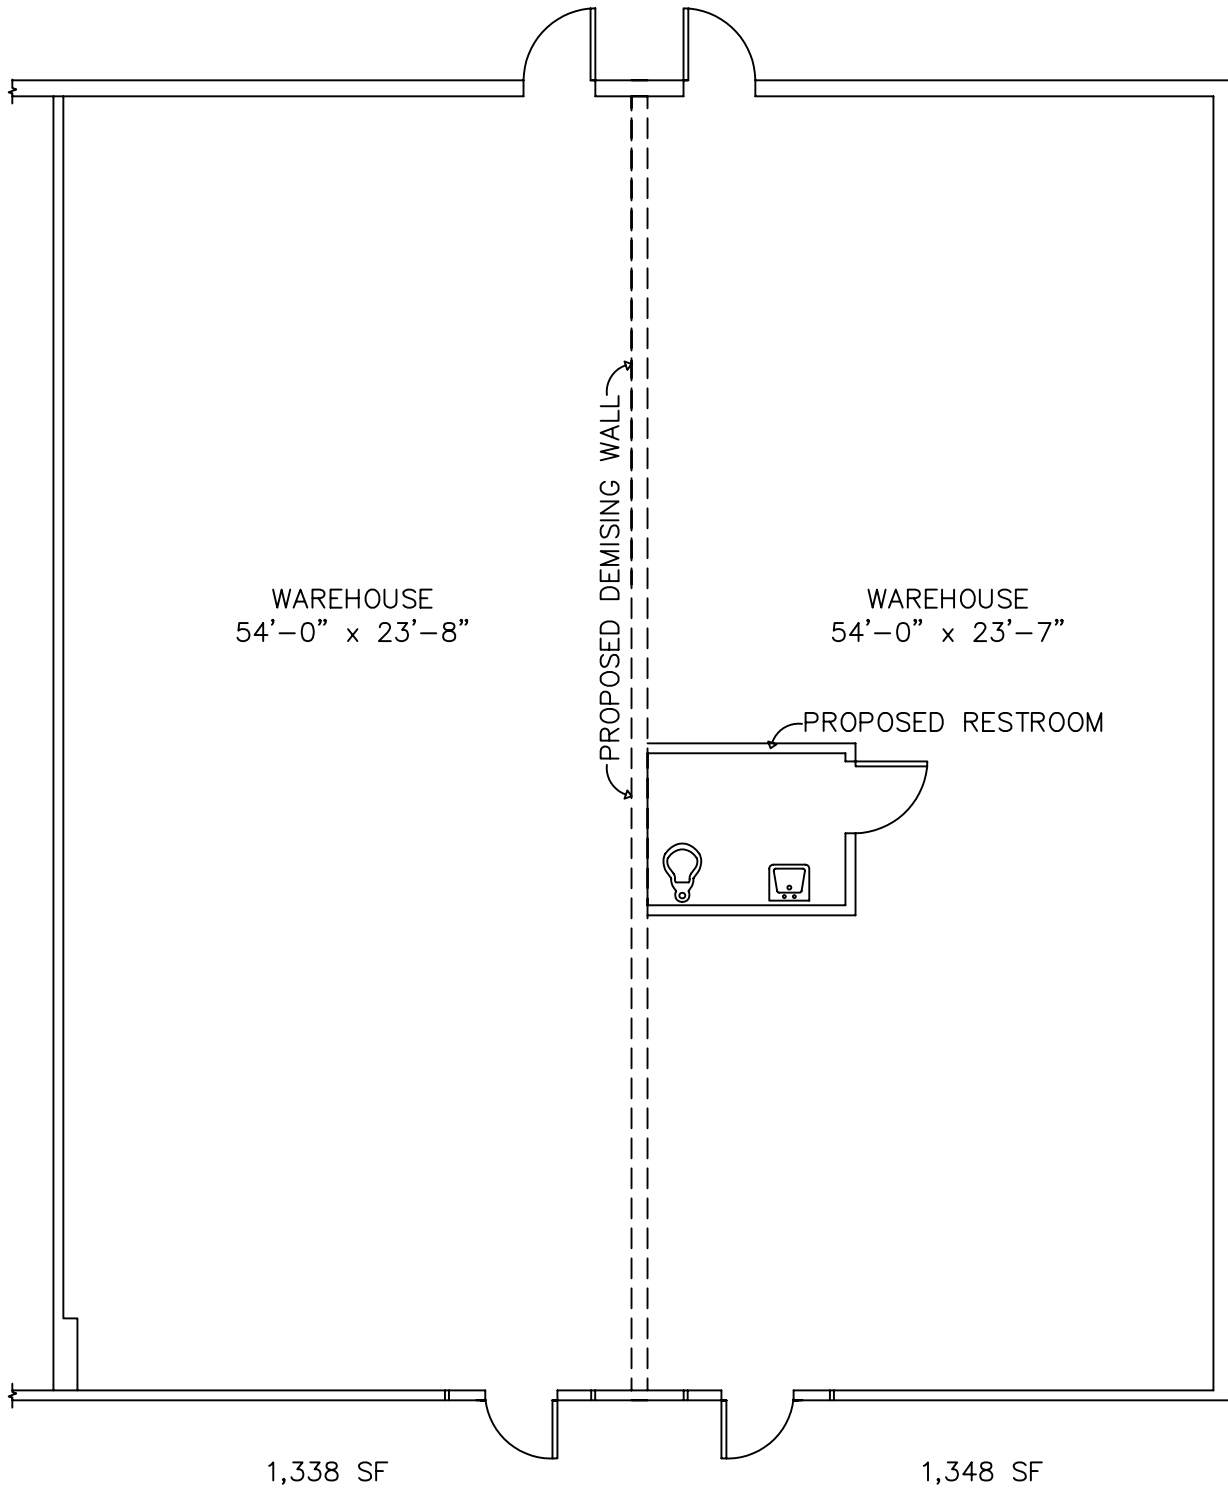

SUITE 124-128 AS-BUILT 2,695 SF

1/8" = 1'

